

0 1 2 3 4 5 10 15 20 25 metres

1 : 100 Scale Bar @ A1



Existing Site Plan

SCALE 1:00

Red broken line denotes site of pergola



Proposed Site Plan

SCALE 1:00


Red broken line denotes site of pergola

0 1 2 3 4 5 10 15 20 25 metres

1 : 100 Scale Bar @ A1



Example Image of Oak Framed Pergola

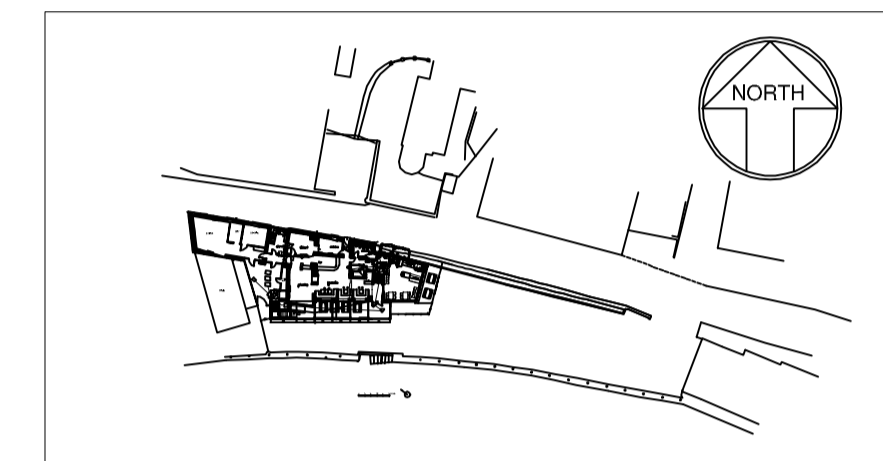

Existing Location Plan

SCALE 1:1250

0 10 20 30 40 50 100 metres


1 : 1250 Scale Bar

Existing Block Plan

SCALE 1:500

0 10 20 30metres

1 : 5 0 0 Scale Bar

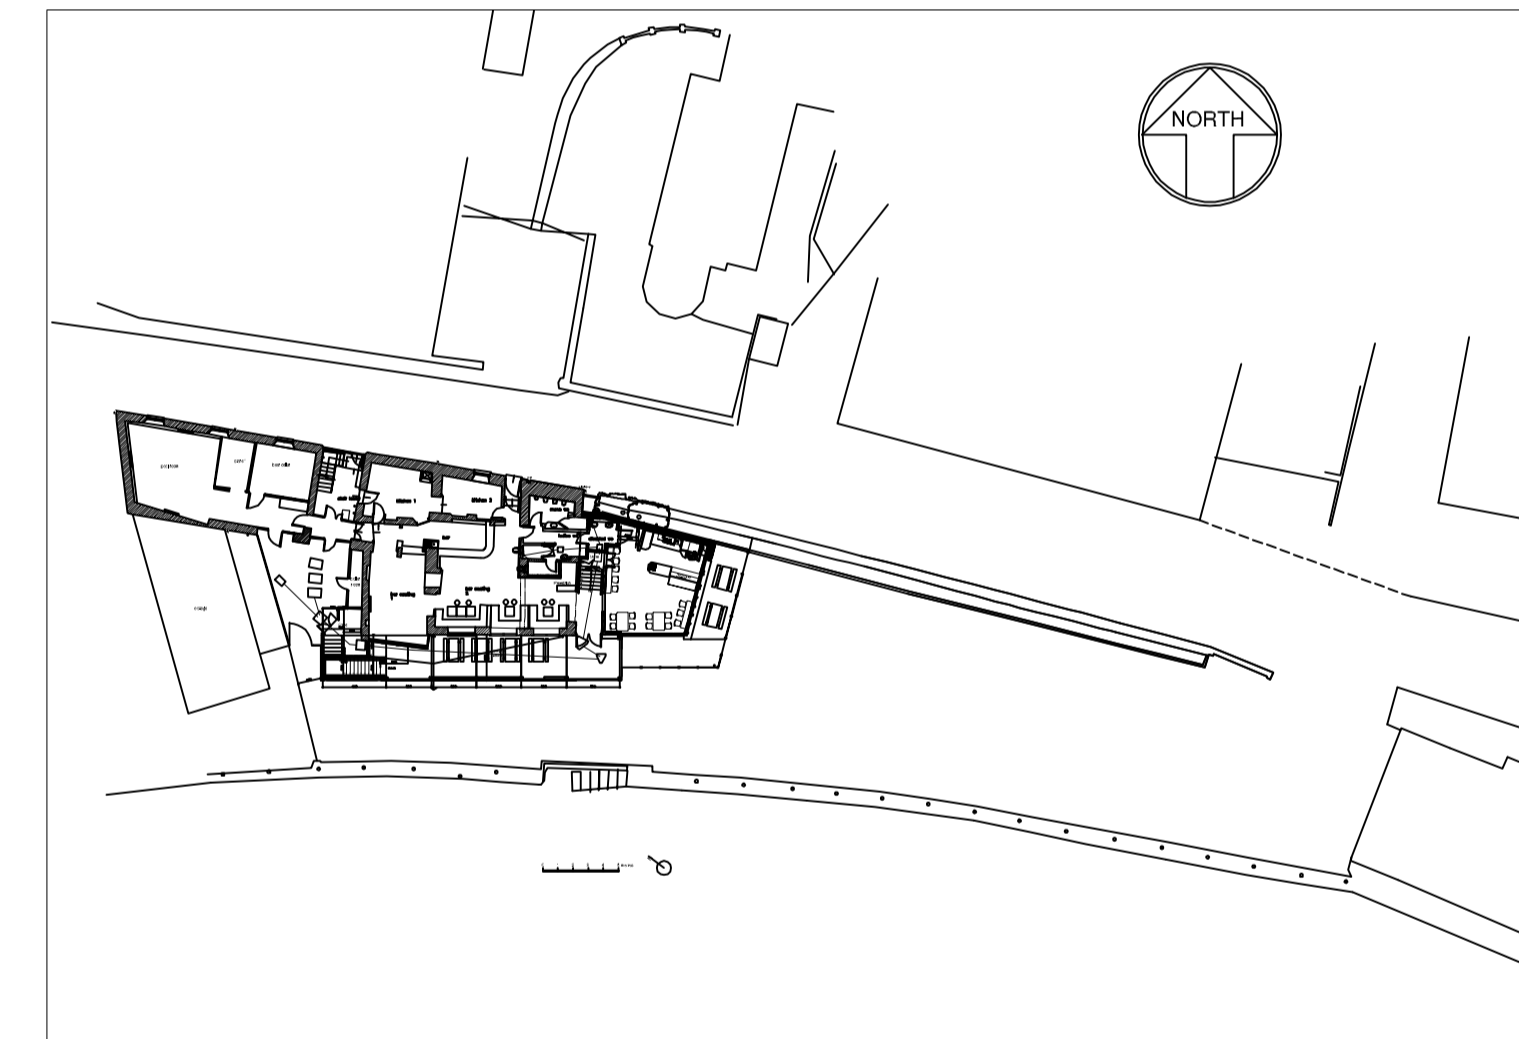

Example Detail Image of Oak Framed Pergola



MP2 Design Architects Ltd

The Stables
Lower Town
Malborough
Devon.
TQ7 3RR

MP
DESIGN

Tel:
01548 561748
Mob:

07970207453 | 7768436805

michael@mp2design.co.uk
amanda@mp2design.co.uk
www.mp2design.co.uk

Project

The Crabshell Inn,
Kingsbridge, South Devon

Drawing Title

Proposed Green Oak
Framed Al-Fresco seating
area with pergola.

Drawing
Number

CO 01

Scale

As annotated

Date

February 2022

Drawn by:

Michael Phillips BA Dip Arch ARB RIBA


The contents of this drawing and the designs
depicted are, and remain the exclusive property,
under copyright of the author MP2 Design,
Chartered Architects Ltd.
This drawing is representative of the building
and elements depicted, do not scale from the
drawing, use written dimensions only and
verify all dimensions on-site.

Revisions:

Status:

Issued for Client Review
21st February 2022
Prior to submission for
Planning Permission

DO NOT SCALE THIS DRAWING OR INTERROGATE DRAWING FILE.
 CONTRACTORS WILL BE HELD RESPONSIBLE FOR TAKING AND CHECKING
 ALL CRITICAL DIMENSIONS ON SITE.

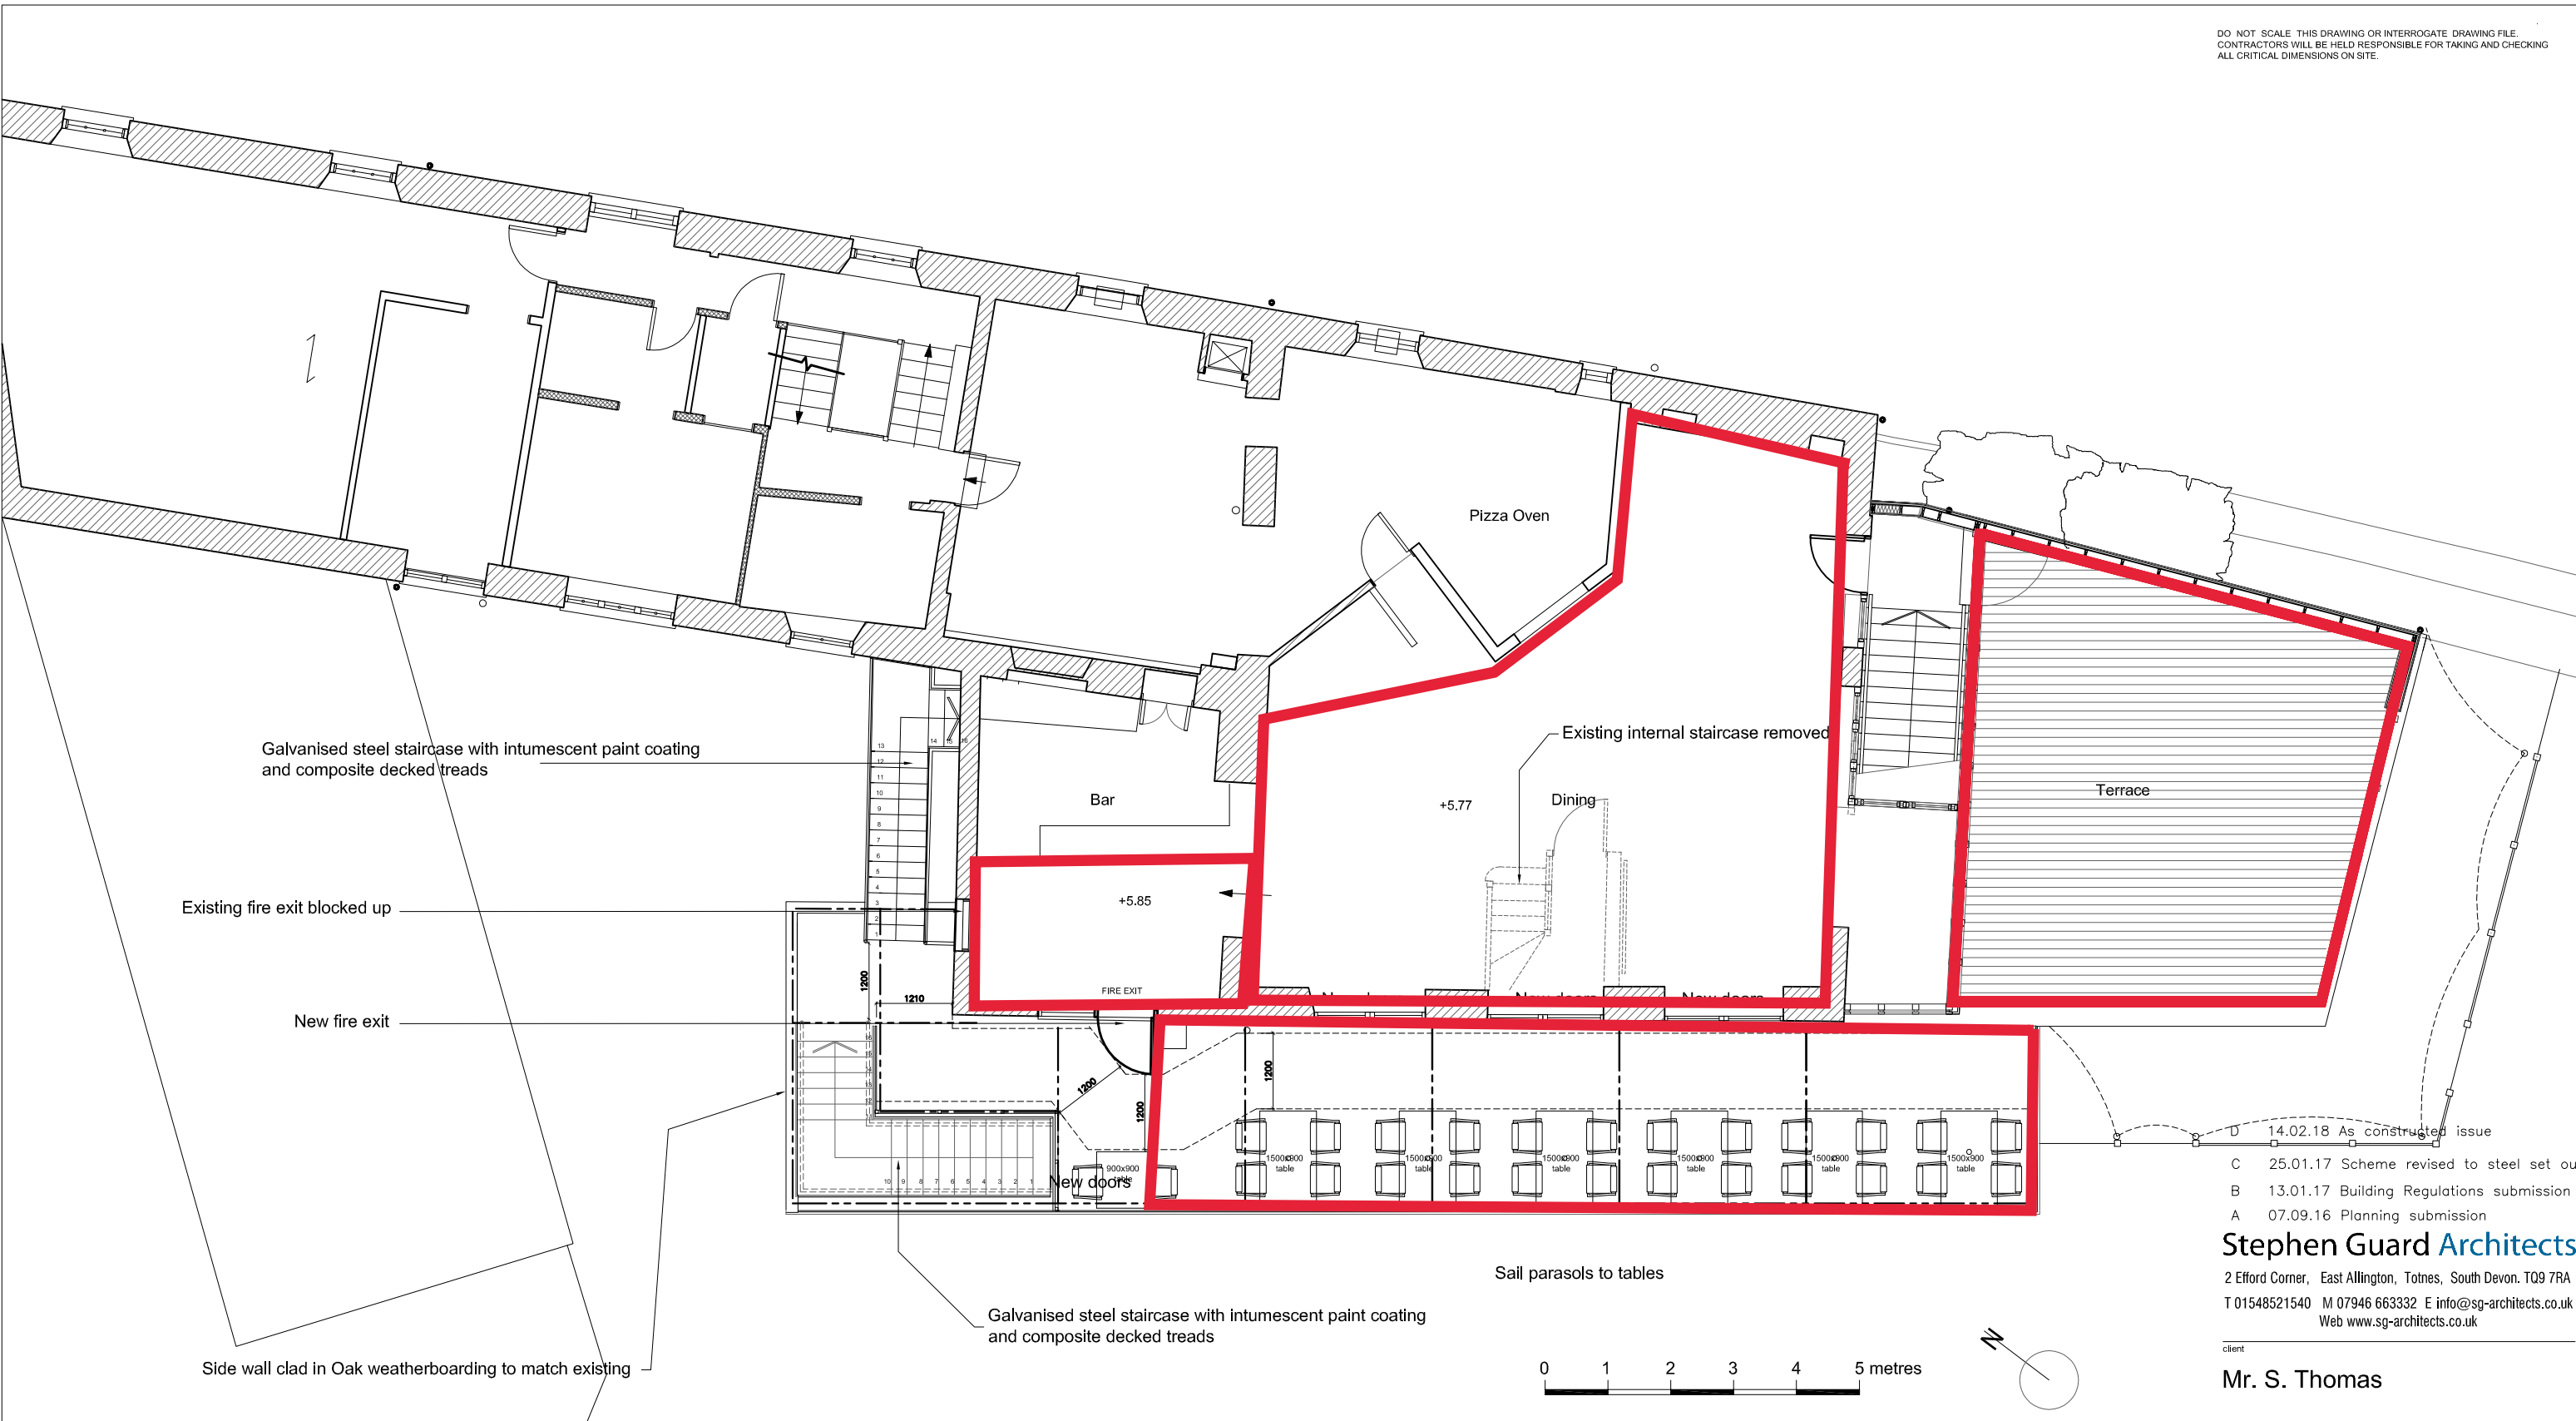

D 14.02.18 As constructed issue
 C 25.01.17 Scheme revised to steel set out
 B 13.01.17 Building Regulations submission
 A 07.09.16 Planning submission

Stephen Guard Architects
 2 Efford Corner, East Allington, Totnes, South Devon. TQ9 7RA
 T 01548521540 M 07946 663332 E info@sg-architects.co.uk
 Web www.sg-architects.co.uk

client
Mr. S. Thomas

project
 New 1st floor balcony and stairs to 2nd floor
 The Crabshell Inn, Kingsbridge

drawing
Proposed First Floor Plan

date	scale	drawn	checked
July 2016	1:100	sg	sg

status

FOR INFORMATION

job no	dwg no	revision
SG16-05 /06		D